


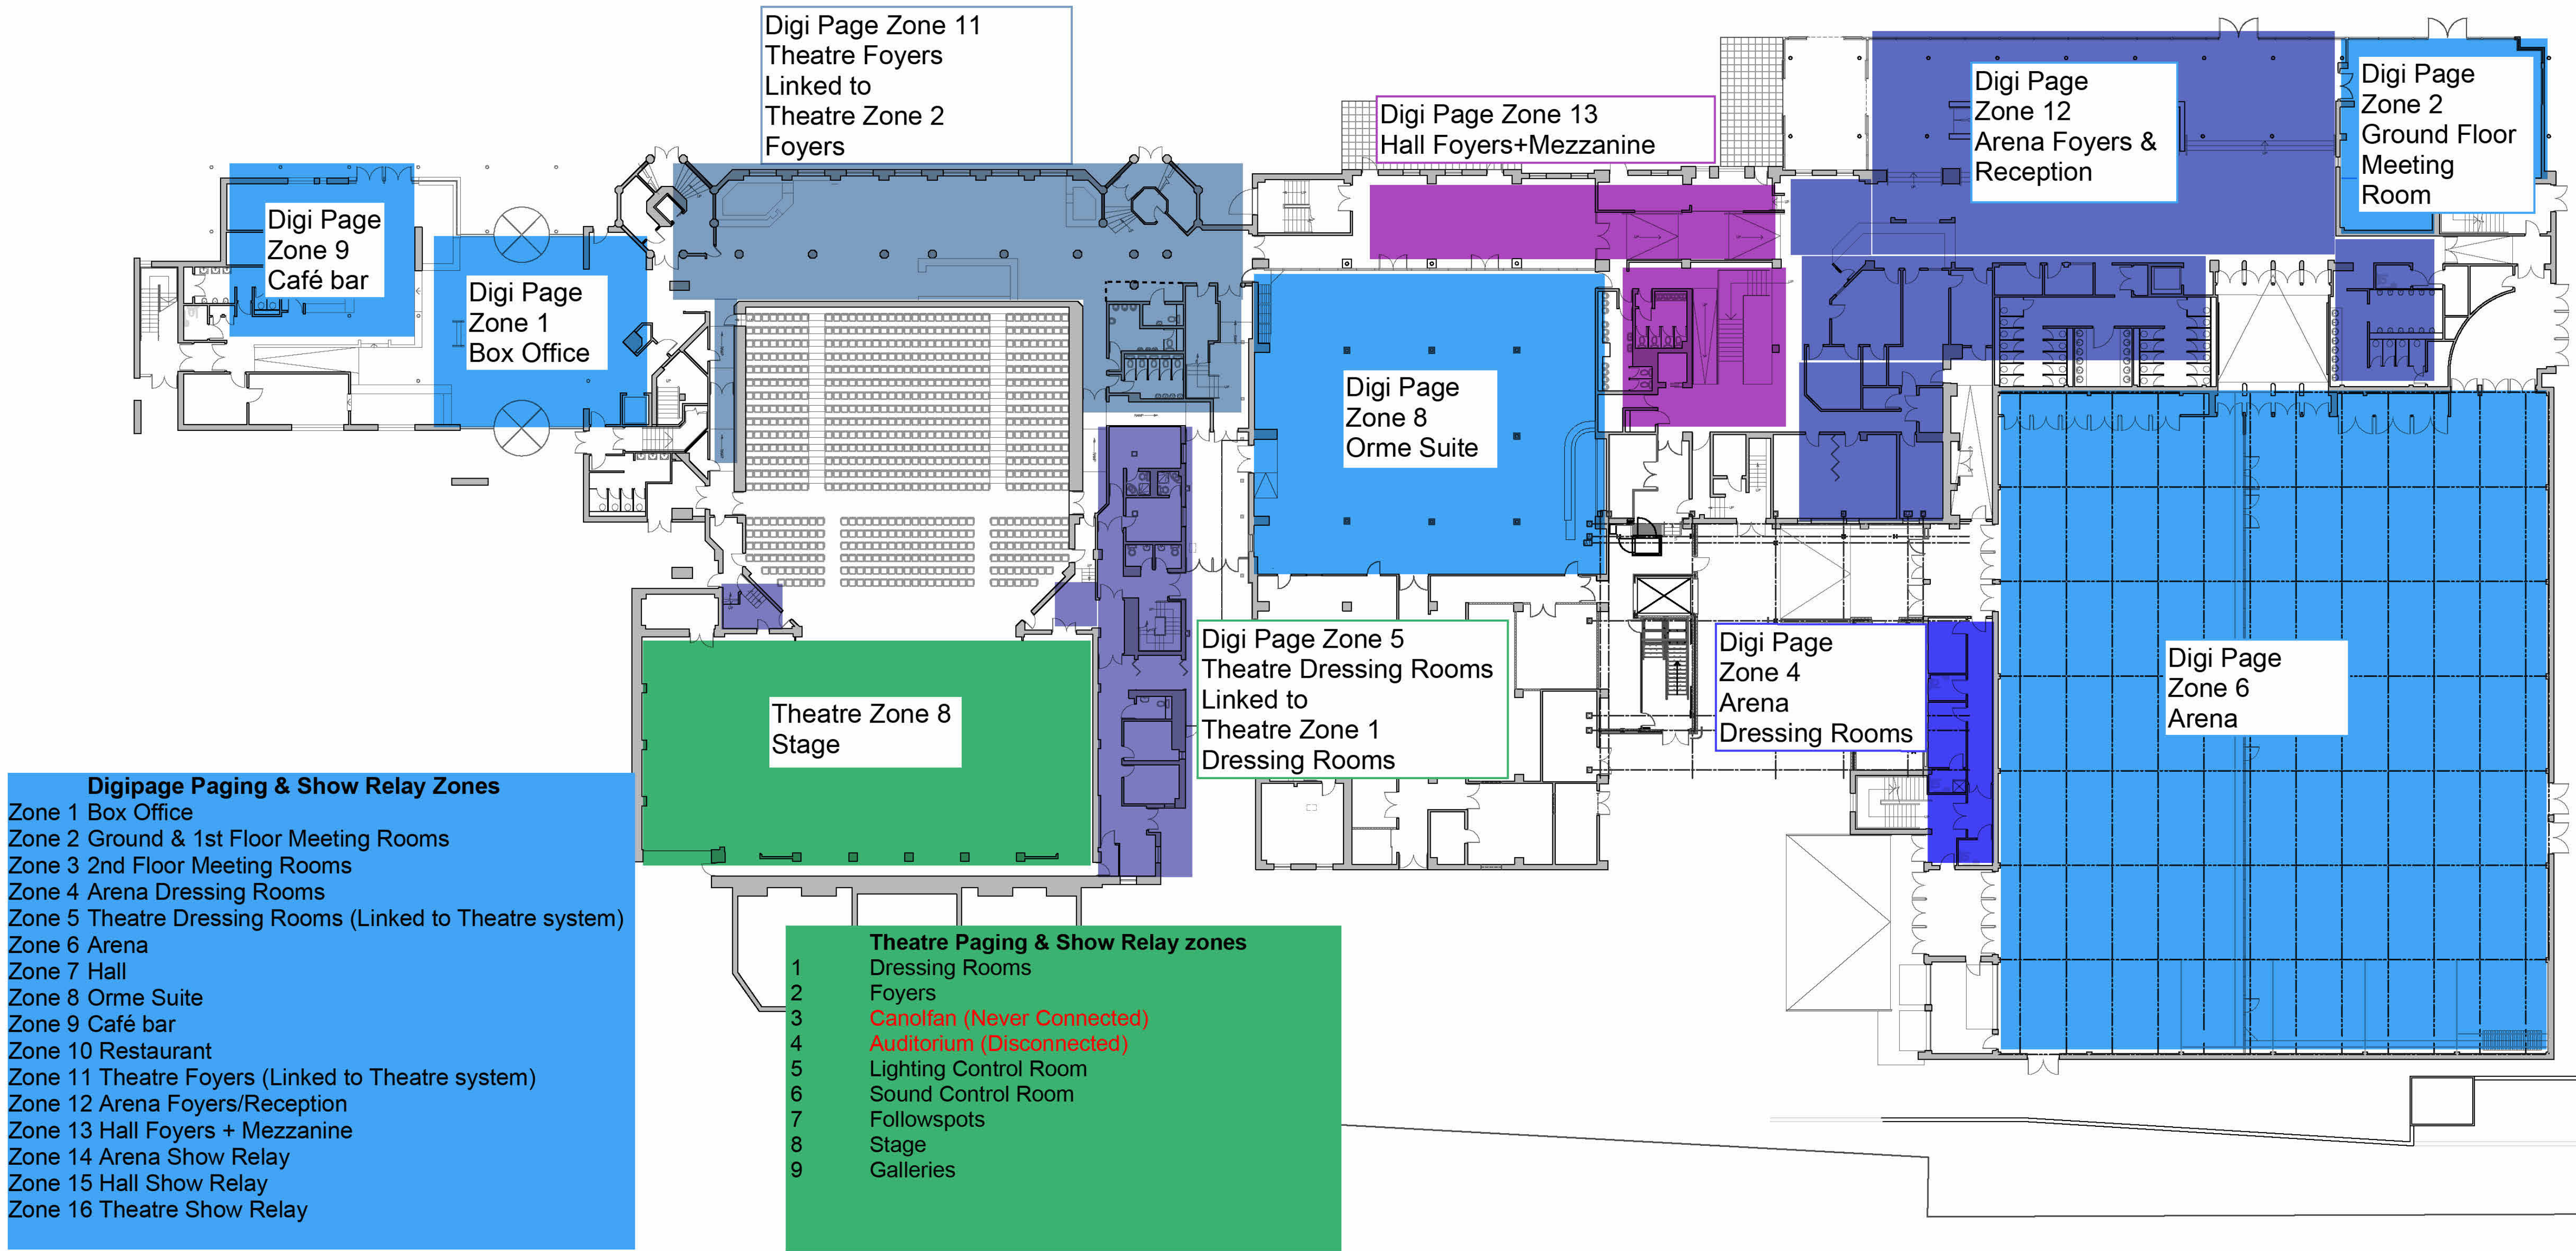

- Digipage Paging & Show Relay Zones**
- Zone 1 Box Office
 - Zone 2 Ground & 1st Floor Meeting Rooms
 - Zone 3 2nd Floor Meeting Rooms
 - Zone 4 Arena Dressing Rooms
 - Zone 5 Theatre Dressing Rooms (Linked to Theatre system)
 - Zone 6 Arena
 - Zone 7 Hall
 - Zone 8 Orme Suite
 - Zone 9 Café bar
 - Zone 10 Restaurant
 - Zone 11 Theatre Foyers (Linked to Theatre system)
 - Zone 12 Arena Foyers/Reception
 - Zone 13 Hall Foyers + Mezzanine
 - Zone 14 Arena Show Relay
 - Zone 15 Hall Show Relay
 - Zone 16 Theatre Show Relay

- Theatre Paging & Show Relay zones**
- 1 Dressing Rooms
 - 2 Foyers
 - 3 Canolfan (Never Connected)
 - 4 Auditorium (Disconnected)
 - 5 Lighting Control Room
 - 6 Sound Control Room
 - 7 Followspots
 - 8 Stage
 - 9 Galleries

Notes:-
All dimensions to be verified on site.
Do not scale from this drawing
Drawing should be printed in colour for clarity.
This drawing should be read in conjunction with the Paging section of the Facilities Planning Schedule and the Paging general arrangement drawings.

This markup provided by the client (Venue Cymru) indicates the coverage and zoning of the 2 existing paging systems at Venue Cymru, referred to in Charcoalblue documentation as:

'Theatre System' which was the original paging system installed when building opened and covers only the theatre spaces (backstage, front of house, control rooms, stage)

'Digipage System' which was installed in the early 2000s which covers the arena and conference areas of the building.

There are links between the 2 systems
Digipage Zone 11 and Theatre Zone 2 are the Theatre Foyers
Digipage Zone 5 and Theatre Zone 1 are the Theatre Dressing Rooms.

For these 2 zones, paging stations on either system can be used to make calls to these zones.

The Charcoalblue design for the paging system will replace the entire control system, and the existing backstage paging for the theatre.

The Digipage **control** system is required to be decommissioned and control of the amplifiers, loudspeakers and Arena show relay will be via the new control system.

The Front of House theatre zone 2 is fed covered by a PAVA system which the client advises is not up to current standards.

The specialist contractor as part of this tender should seek suitable guidance from a Fire Consultant on whether the PAVA amplifiers and loudspeaker system is still suitable for purpose and advise the client of the best solution to maintain a front of house announcement system.

Venue Cymru will be having additional work to remodel part of the front of house areas in the coming years, therefore it is advised that when this work takes place, the paging system for front of house is updated as part of that work.

A	TENDER	10/11/2025
Rev	Description	Date

Project title:

VENUE CYMRU, LLANDUDNO

Drawing Title:

AUDIOVISUAL SYSTEMS - PAGING

GROUND FLOOR WHOLE SITE

STAGE

Drawing Type:

CLIENT MARKUP

CHARCOALBLUE



**THEATRICAL
INNOVATION** | **ESTD
2004**

17 Short Street, London SE1 8LJ
T +44 (0)20 7928 0000
www.charcoalblue.com

Scale	Size	Status	
NTS	A1	Tender	
Drawn	Date	Checked	Date
DB	10/10/25	JN	05/11/2025
DRAWING NUMBER			REV
LVC-CBL-PAG-GA-009			A